

OFFICE OF THE EXECUTIVE ENGINEER, PWD CITY DN. III, JAIPUR
 No:-EE-III/BSC/D-..^{०६}..

Date :- 11. 4. 2022

The Principal/ Head Master/ Secretary

.....VARDHMAN...SRIKALYAN...International School
Kaliyana....Road...Jaipur

Jaipur

Sub: Building Completion cum Safety Certificate of Educational Institute

.....VARDHMAN...SRIKALYAN...International School
Hathoda...Kaliyana...Road...Jaipur.....

Sir,

It is to be informed that above building has been inspected by

Assistant Engineer PWD Sub Dn Education North/ South, Jaipur on
 dated...^{०६}
~~11-4-22~~..... On the basis of information given in Annexure A and affidavit
 furnished by School/ College authority in Annexure B, and recommendation of
 Assistant Engineer, it is certified that this building is complete as per rule and safe for
 school/ college activities.

This certificate is valid for a period of **3 (Three) Years** from the date of issue
 subject to regular upkeep and satisfactory annual maintenance by school / college
 owner.

**Note:- This certificate will stand void automatically if the building is used for
 any other purpose other than the school / college activities at any time
 during valid period, the fire safety measure must be checked by the
 Education Department authority at their on level.**

Principal


Vardhman Srikanth International School
 Jaipur



Manager

Vardhman Srikanth International School
 Jaipur

Executive Engineer,
 PWD City Dn. 3
 Jaipur

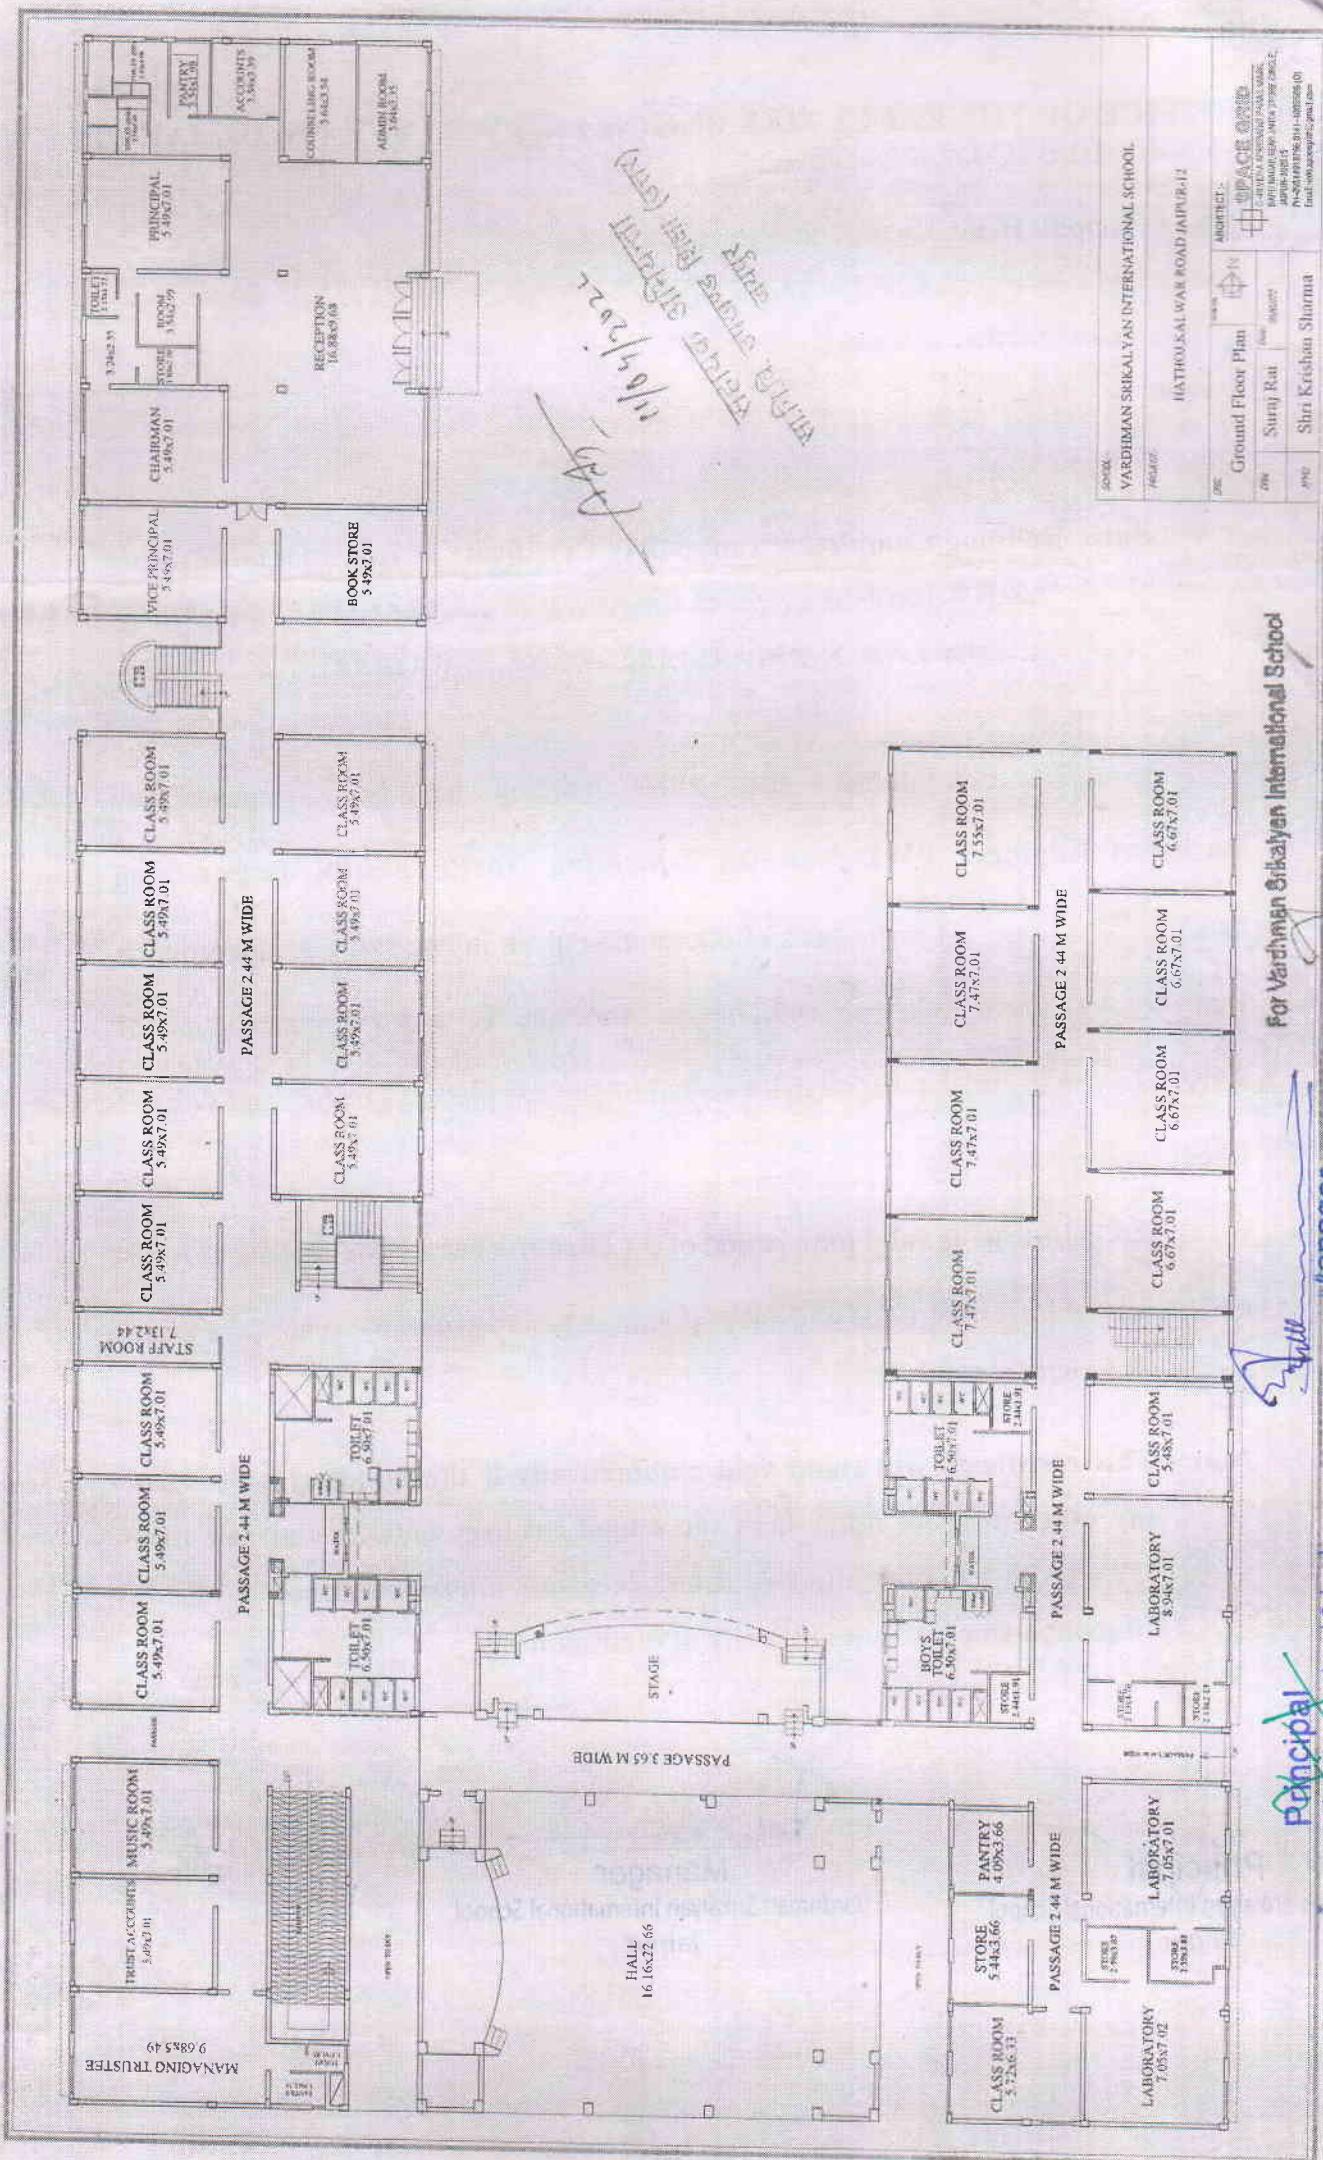


For Vardhaman Shikshayen International School

Manager
ardhman Srikalyan International School
Jaipur

Sri Kalyan International School

Jaipur


Authorized Signatory

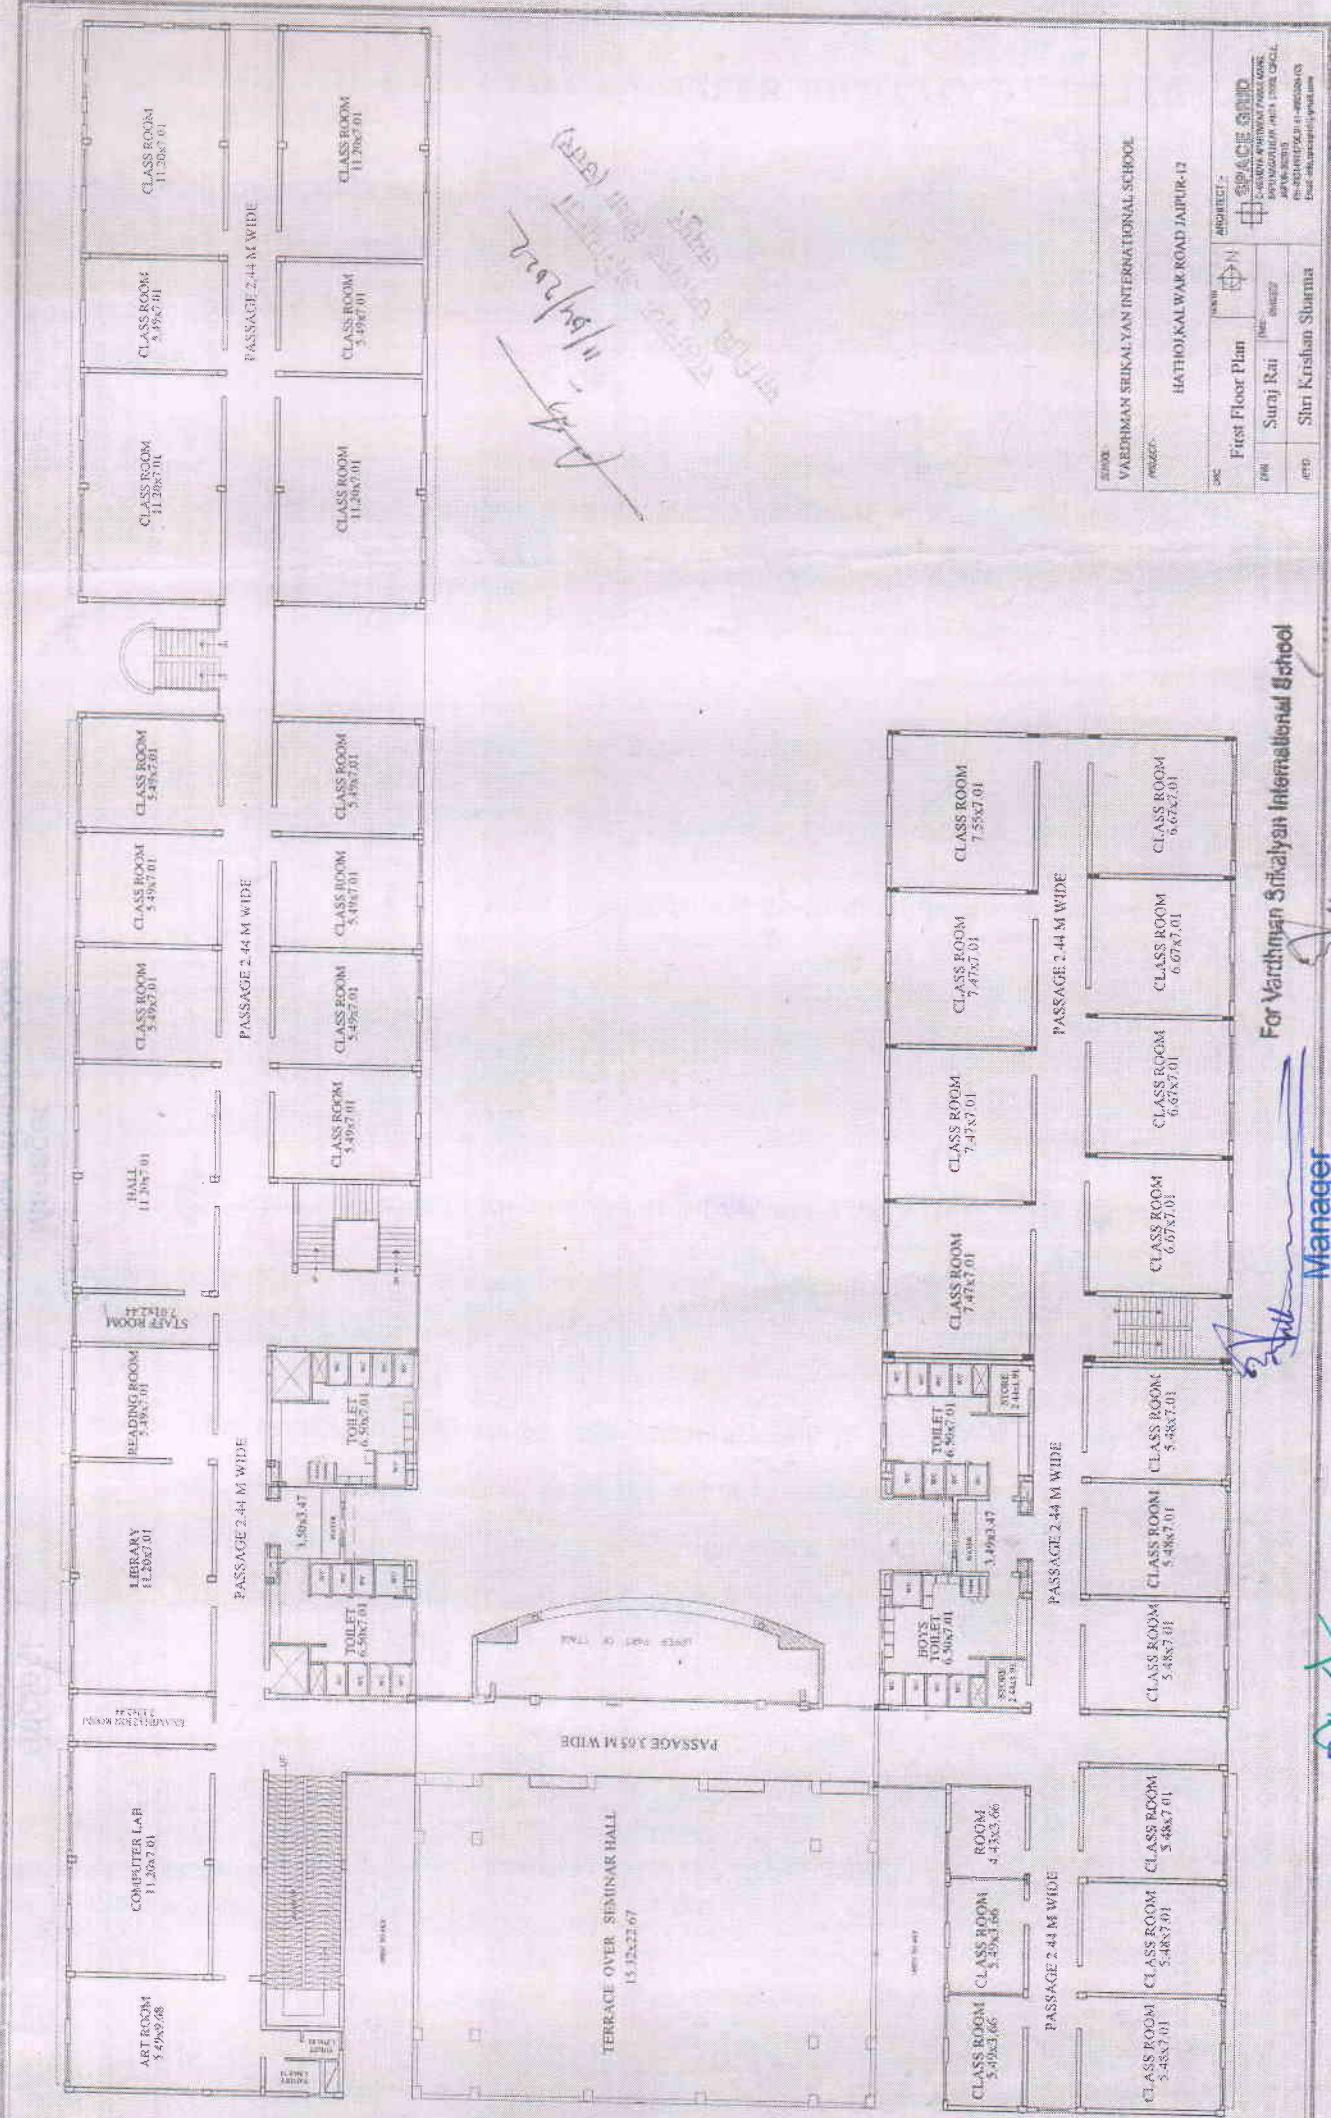


For V

Ardhman Srivastava
Manager
Ardhman Srikanjan International School
Jaipur

~~Principal~~
Vardhman Sikialyan International School
Jaipur

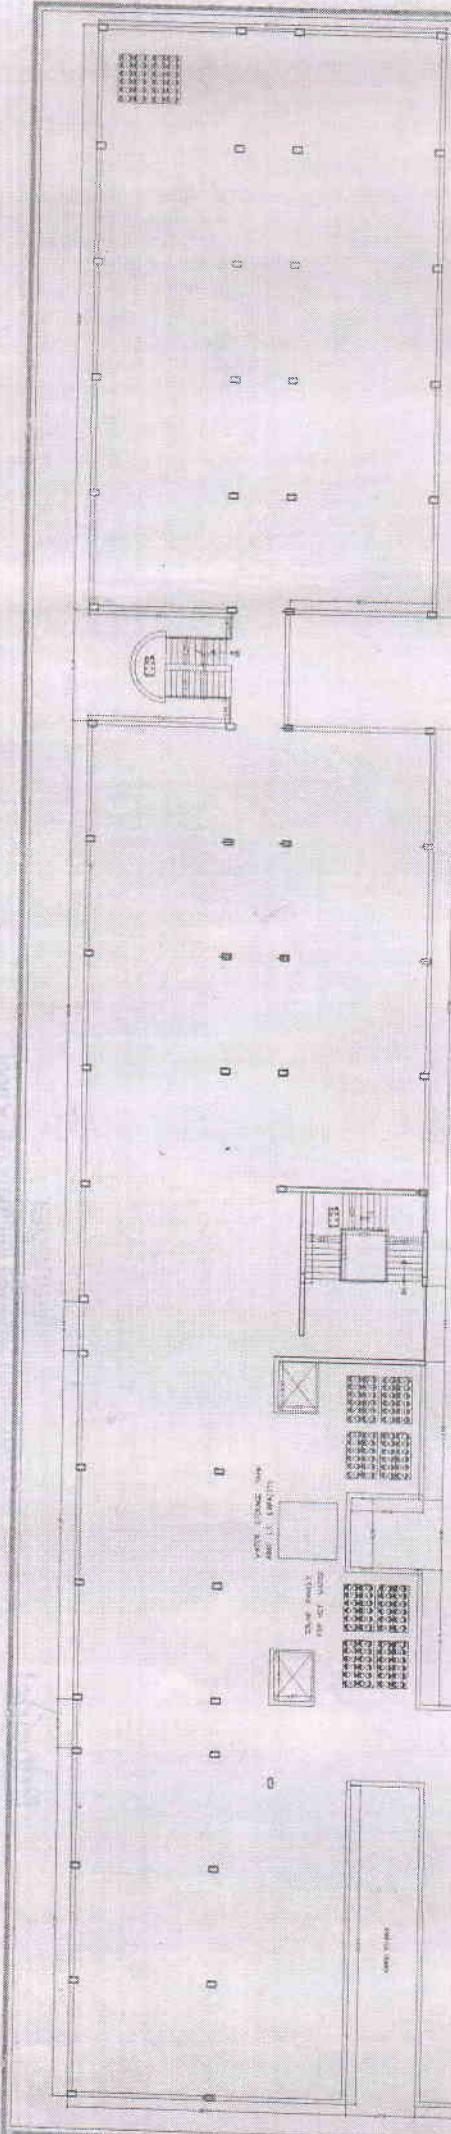

11/11/2022
11/11/2022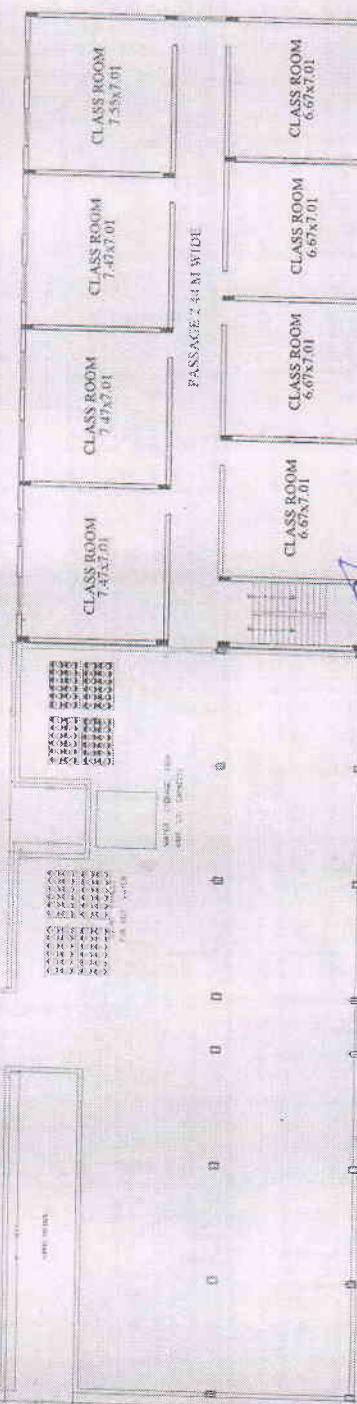
SECOND FLOOR PLAN		DRAWING NO.
NAME	DESIGNATION	DATE
Sunny Rai	Manager	11/11/2022
Shri Krishan Sharma	Manager	11/11/2022

For Vardhman Sikalyan International School

Vardhman Sikalyan International School
Jaipur
Manager

Authorized Signatory

Official
Vardhman Sikalyan International School
Jaipur